

# AS BUILT INFORMATION


Please fill & submit the following information  
(hard & soft copy in DWG.format)

REGULATIONS		EXISTING	
PLOT AREA	SQ.M.		
	SQ.FT.		
DISTRIBUTION OF GFA & LAND USE	RESIDENTIAL		
	COMMERICAL		
	RETAIL		
	EDUCATIONAL		
	PUBLIC FACILITY		
	INDUSTRIAL		
	STUDIO		
	OTHERS (SPECIFY)		
<b>TOTAL GROSS FLOOR AREA (SQ.FT.)</b>			
NO. OF UNITS	STUDIO		
	ONE BEDROOM		
	TWO BEDROOMS		
	THREE BEDROOMS OR ABOVE		
NO. OF FLOORS	BASEMENT	BY FLOOR	BY METER
	MEZZANINE	BY FLOOR	BY METER
	PODIUM	BY FLOOR	BY METER
	TOWER (G+FLOORS HEIGHT)	BY FLOOR	BY METER
PARKING SPACES			

- As Built Setting Out plan.
- Existing Vehicle Access
- Existing Gate Level
- Utility Connections ( Coordinates & Levels )
- For further clarification see sample :

EXISTING CONNECTION POINTS COORDINATES			
SYMBOL	ITEM	East	North
(E)	ELECTRIC CONNECTION	000000.000	0000000.000
(W)	WATER CONNECTION	000000.000	0000000.000
(D)	SANITARY CONNECTION	000000.000	0000000.000
(DC)	DISTRICT COOLING CONNECTION	000000.000	0000000.000
(FO)	FIBER OPTIC CONNECTION	000000.000	0000000.000

- GATE LEVEL
- ▲ VEHICLE INGRESS
- △ VEHICLE EGRESS
- ① EXISTING COORDINATES
- ┌───┐ LIMITS OF EXISTING BASEMENT FOOT PRINT AREA
- ▨ LIMITS OF EXISTING TOWER FOOT PRINT AREA
- ▨ LIMITS OF EXISTING PODIUM FOOT PRINT AREA

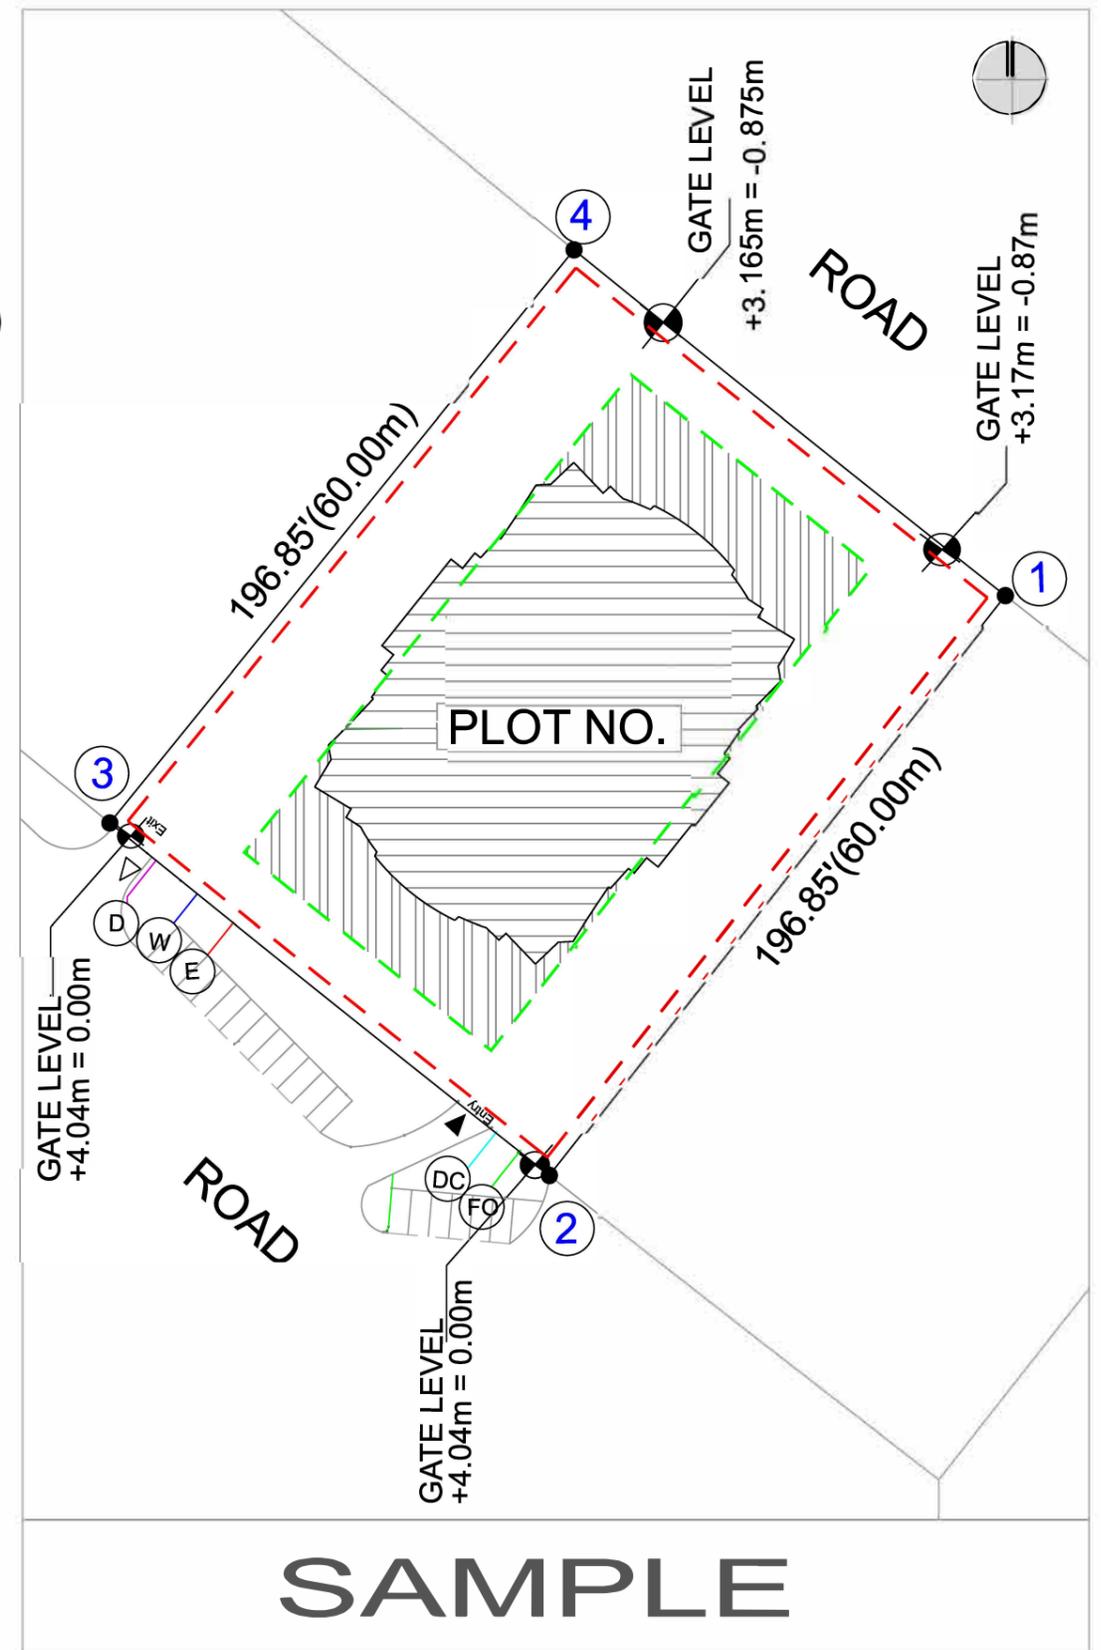

EXISTING COORDINATES					
No.	East	North	No.	East	North
1	000000.000	0000000.000	7	000000.000	0000000.000
2	000000.000	0000000.000	8	000000.000	0000000.000
3	000000.000	0000000.000	9	000000.000	0000000.000
4	000000.000	0000000.000	10	000000.000	0000000.000
5	000000.000	0000000.000	11	000000.000	0000000.000
6	000000.000	0000000.000	12	000000.000	0000000.000

IN CASE OF MORE THAN 12 POINTS PLEASE ATTACH THE REMAINING POINTS WITH THIS SHEET.

PLOT INFORMATION	3rd PARTY SURVEYOR INFORMATION	CONSULTANT'S INFORMATION	CONTRACTOR'S INFORMATION	سلطة دبي للتطوير GOVERNMENT OF DUBAI Dubai Development Authority
PROJECT NAME : PLOT NO. OWNER NAME :	3RD PARTYSURV. NAME : SUBMITTED BY : SIGNATURE/STAMP : DATE :	CONSULTANT NAME : SUBMITTED BY : SIGNATURE/STAMP : DATE :	CONTRACTOR NAME : SUBMITTED BY : SIGNATURE/STAMP : DATE :	AS BUILT SURVEY